
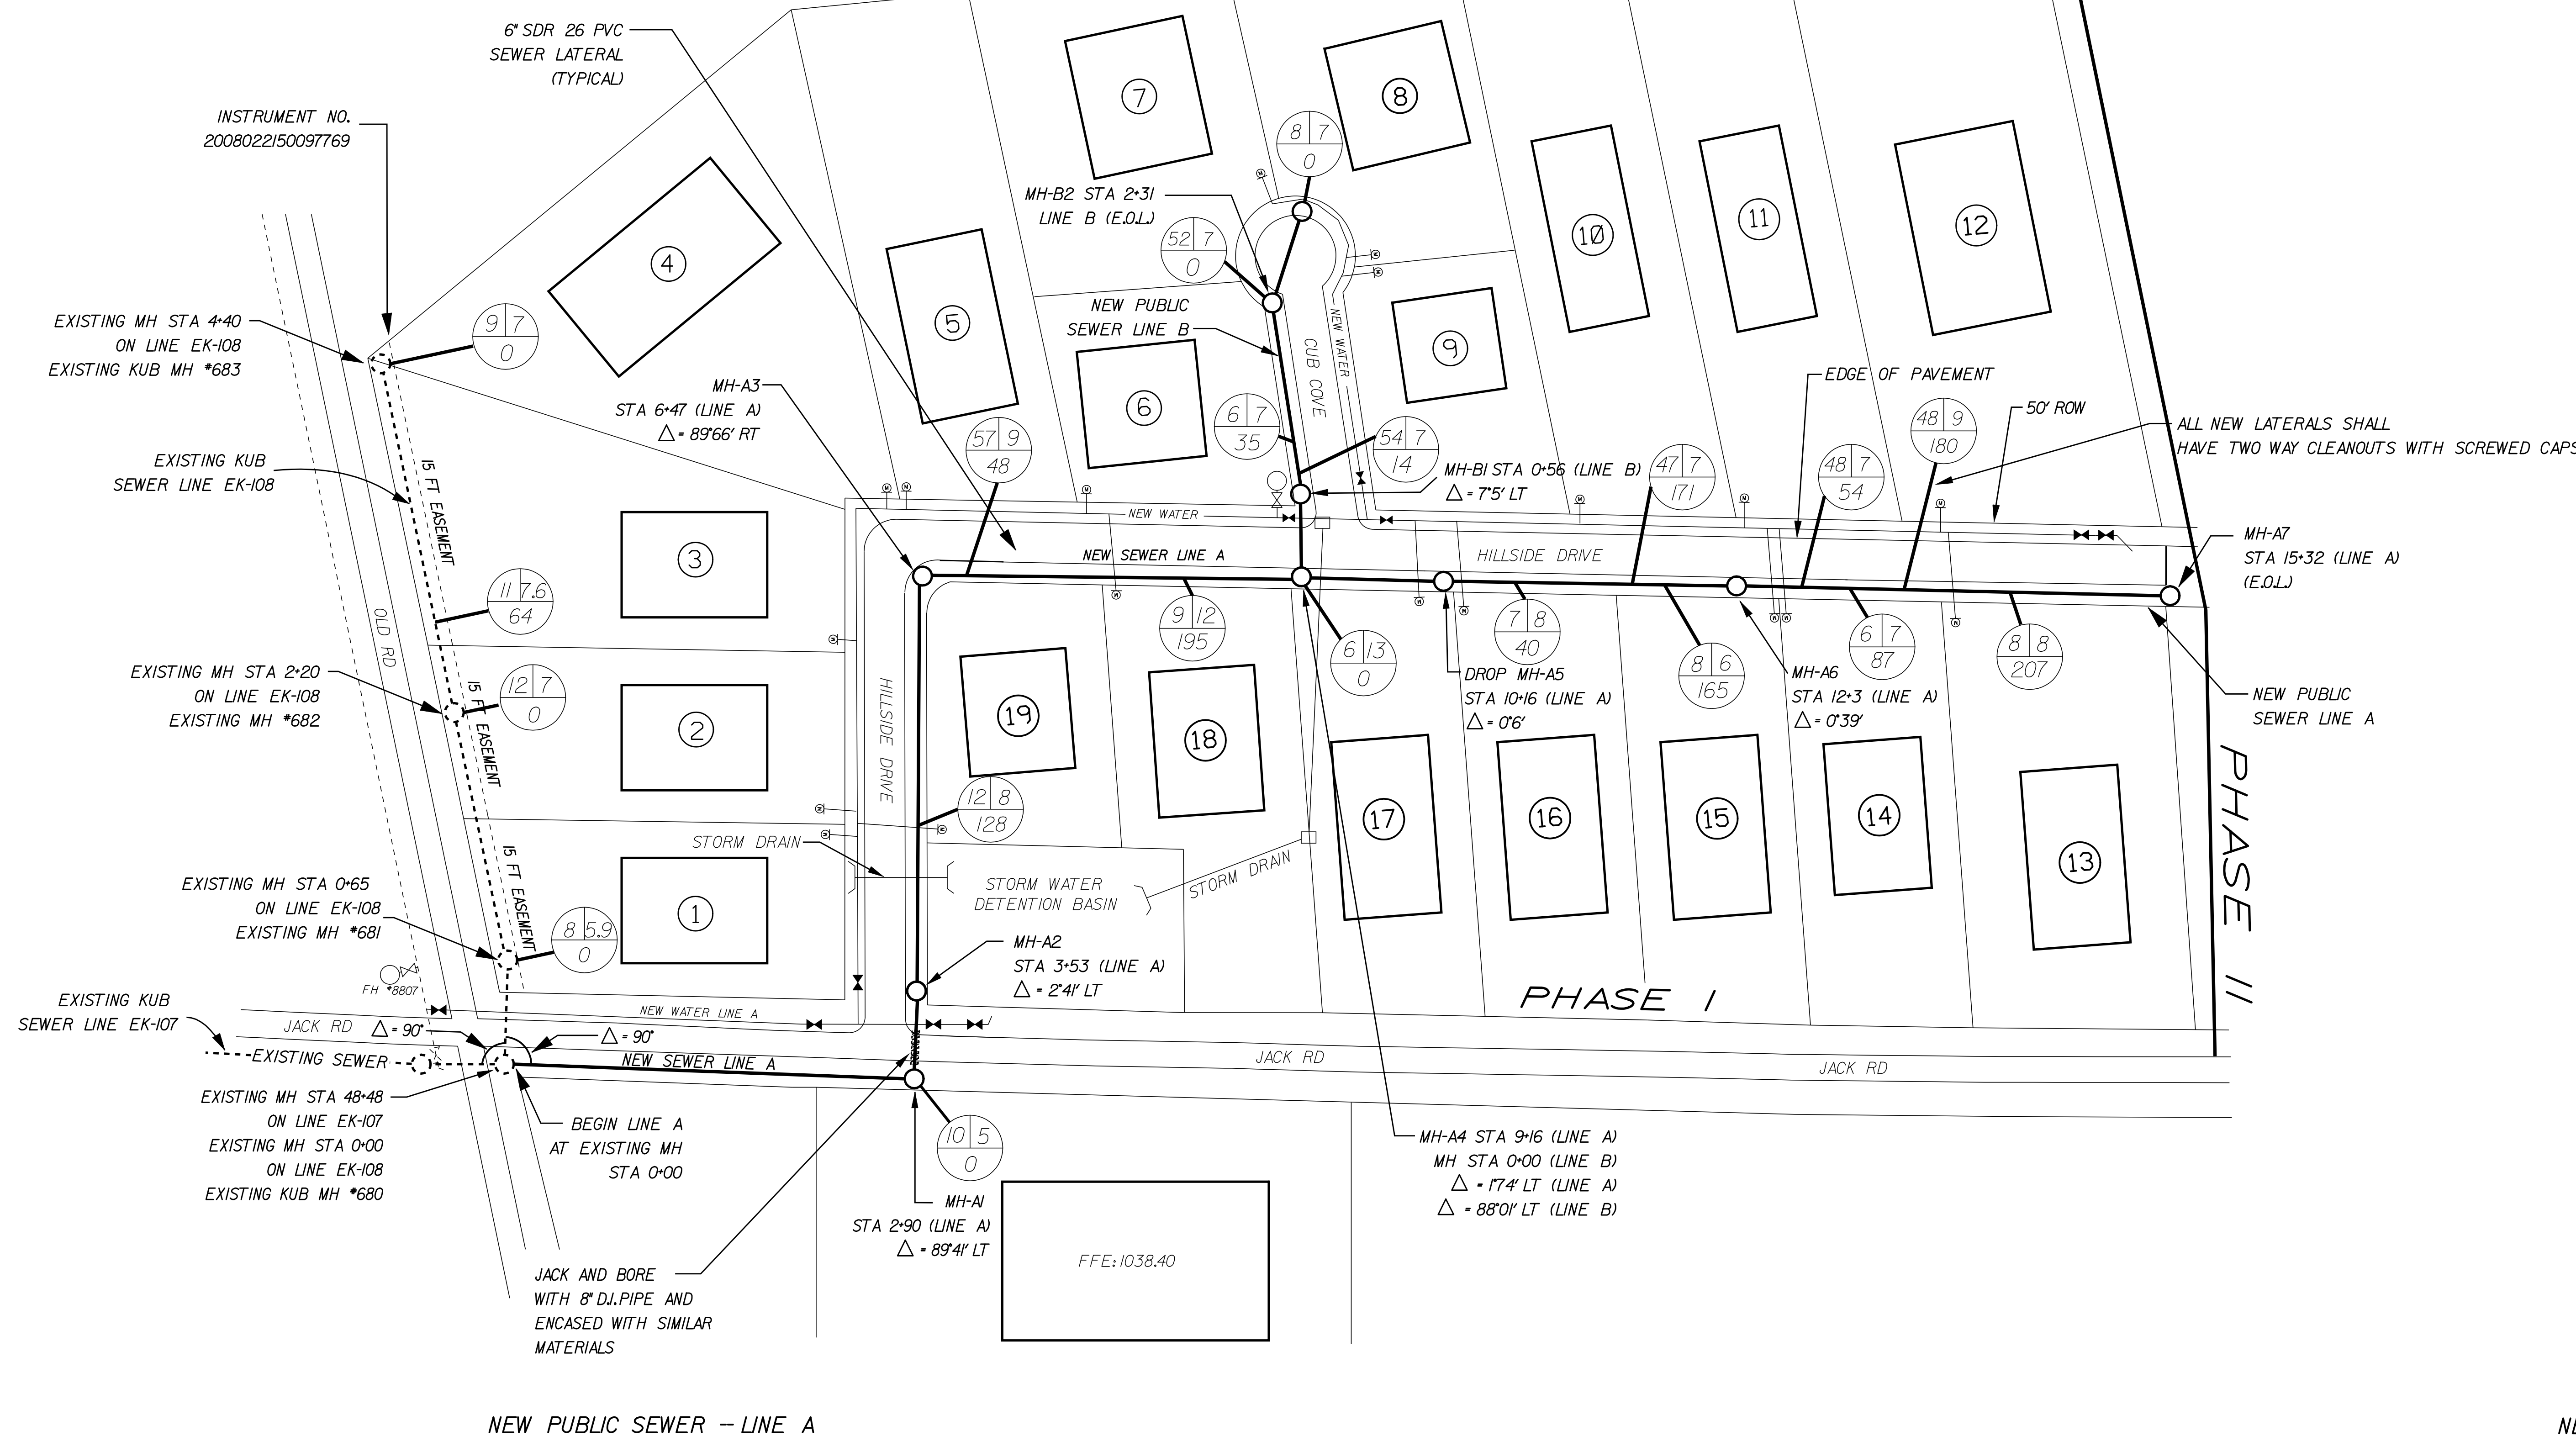


**LEGEND**


- EXISTING SANITARY MANHOLE
  - PROPOSED SANITARY MANHOLE
  - EXISTING SANITARY LINE
  - PROPOSED SANITARY LINE
  - WATER STOP
- WHERE:  
 A - \*FT LENGTH OF THE LATERAL FROM THE MAIN TO THE PROPERTY LINE  
 B - \*FT OF DEPTH WHERE THE LATERAL TAPS INTO THE SEWER MAIN (NOT NECESSARY UNTIL ASBUILT)  
 C - \*FT FROM THE NEAREST DOWNSTREAM MANHOLE

Plan Scale:  
1" = 100'


**LOCATION MAP (N.T.S.)**

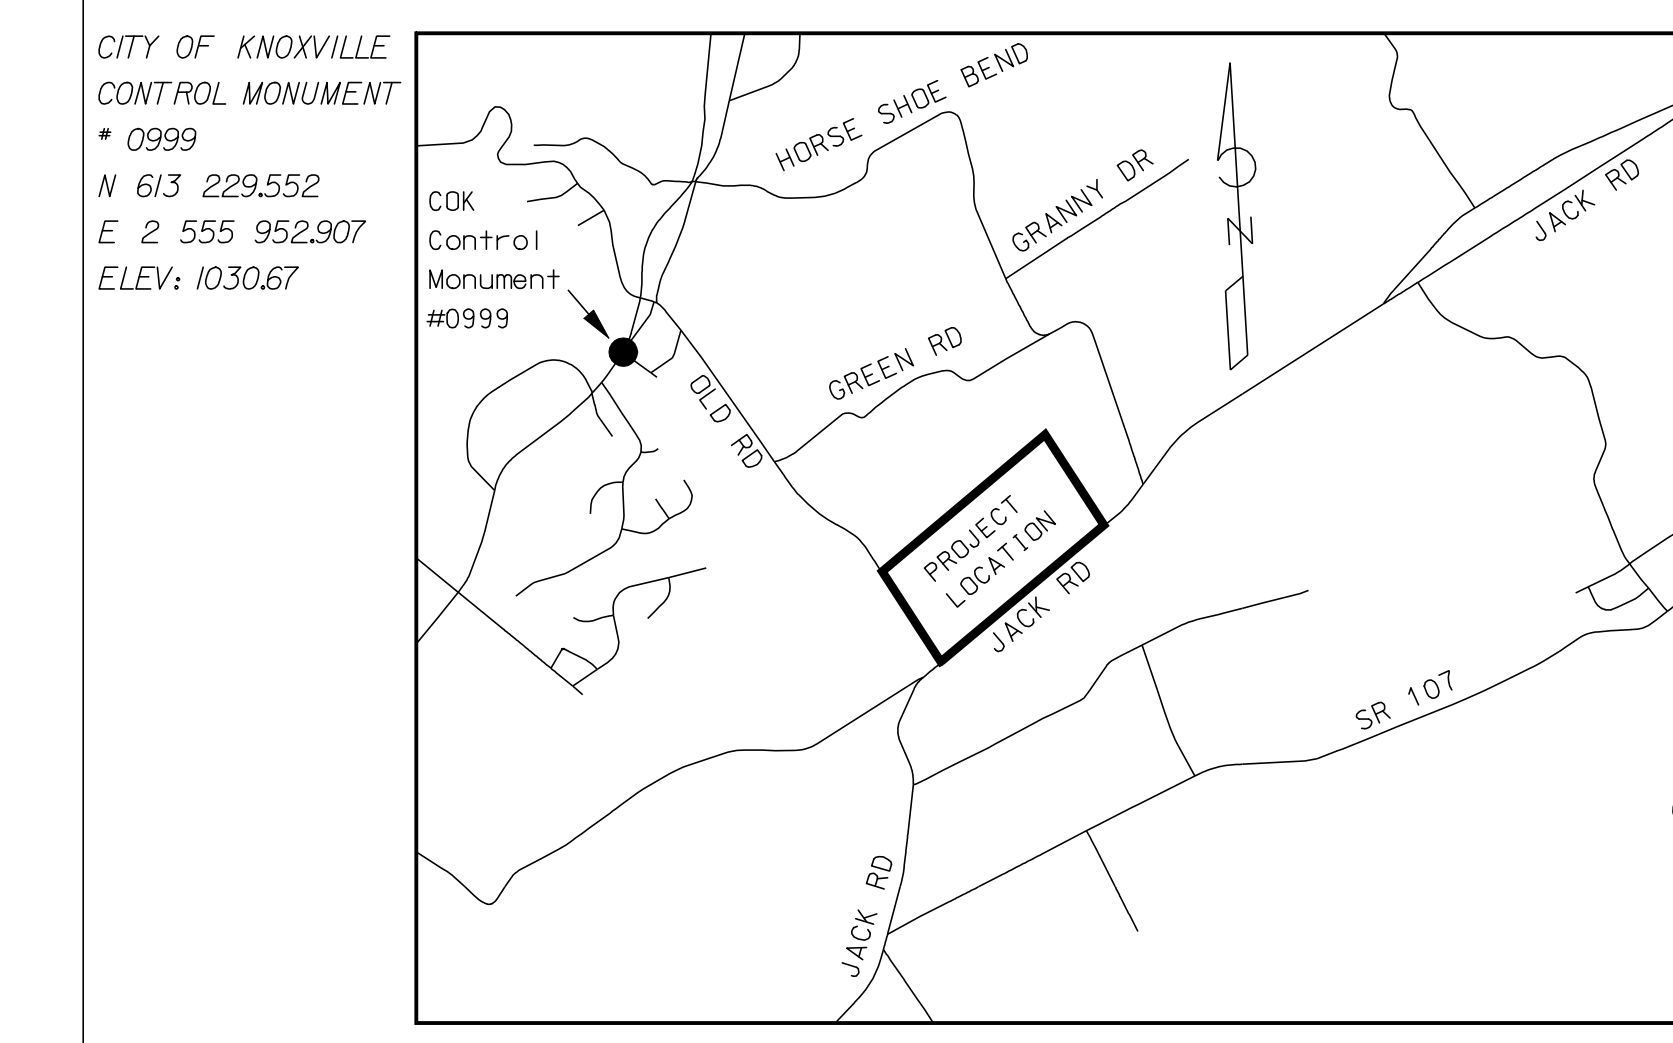

PROPERTY UNITS	
MATERIALS	QTY
MH'S	10
8" D.I.	63'
8" PVC	1746'
LATERALS	20

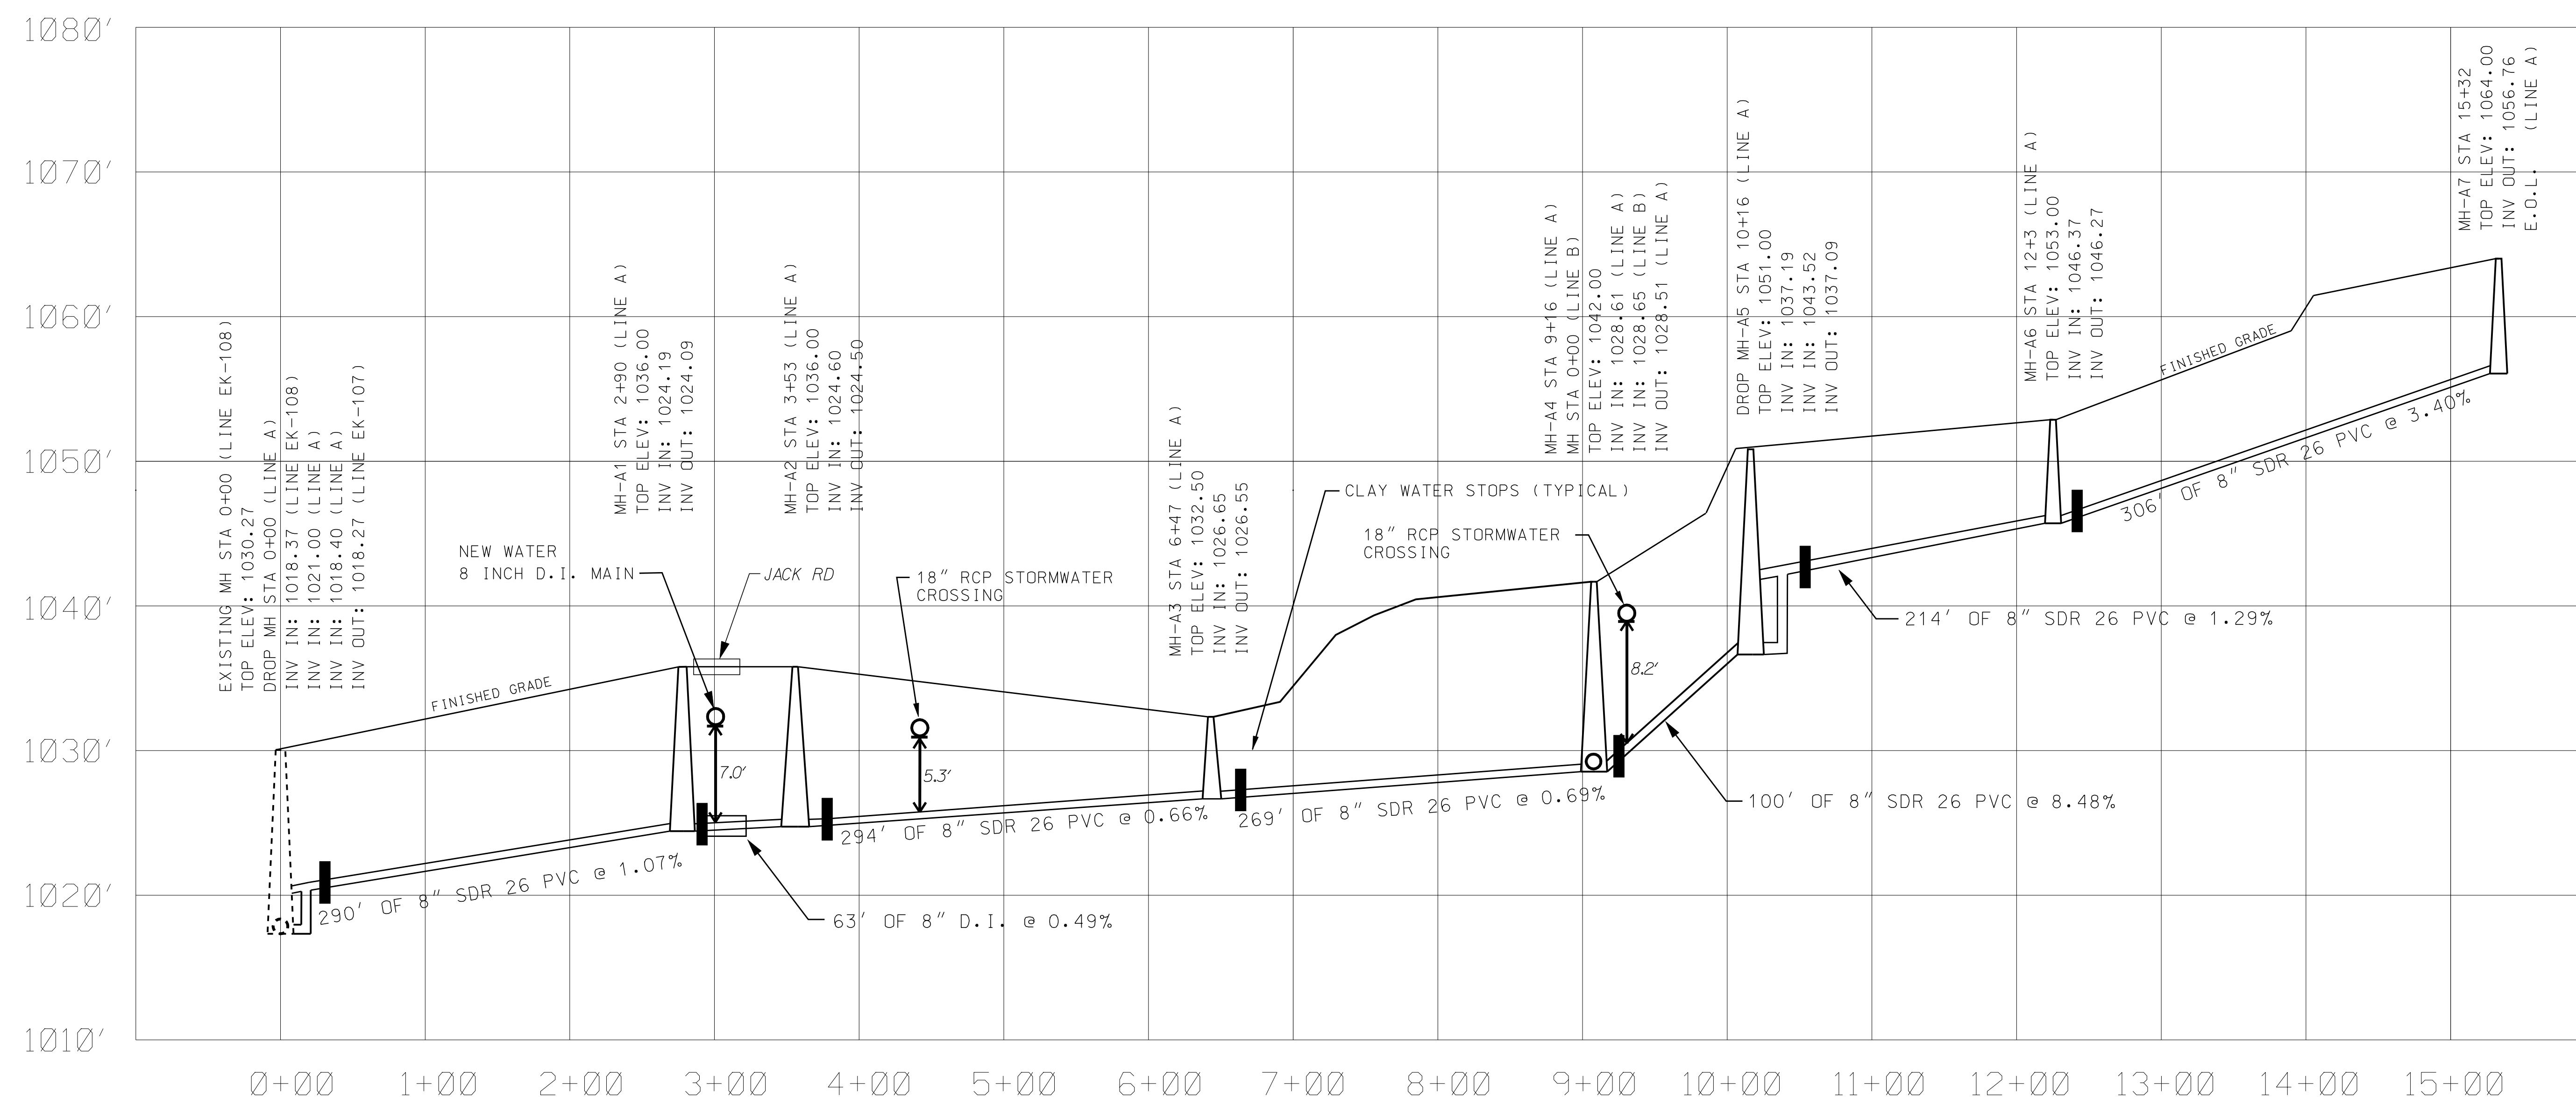

Profile Scale:  
Vertical: 1"=10'  
Horizontal: 1"=100'

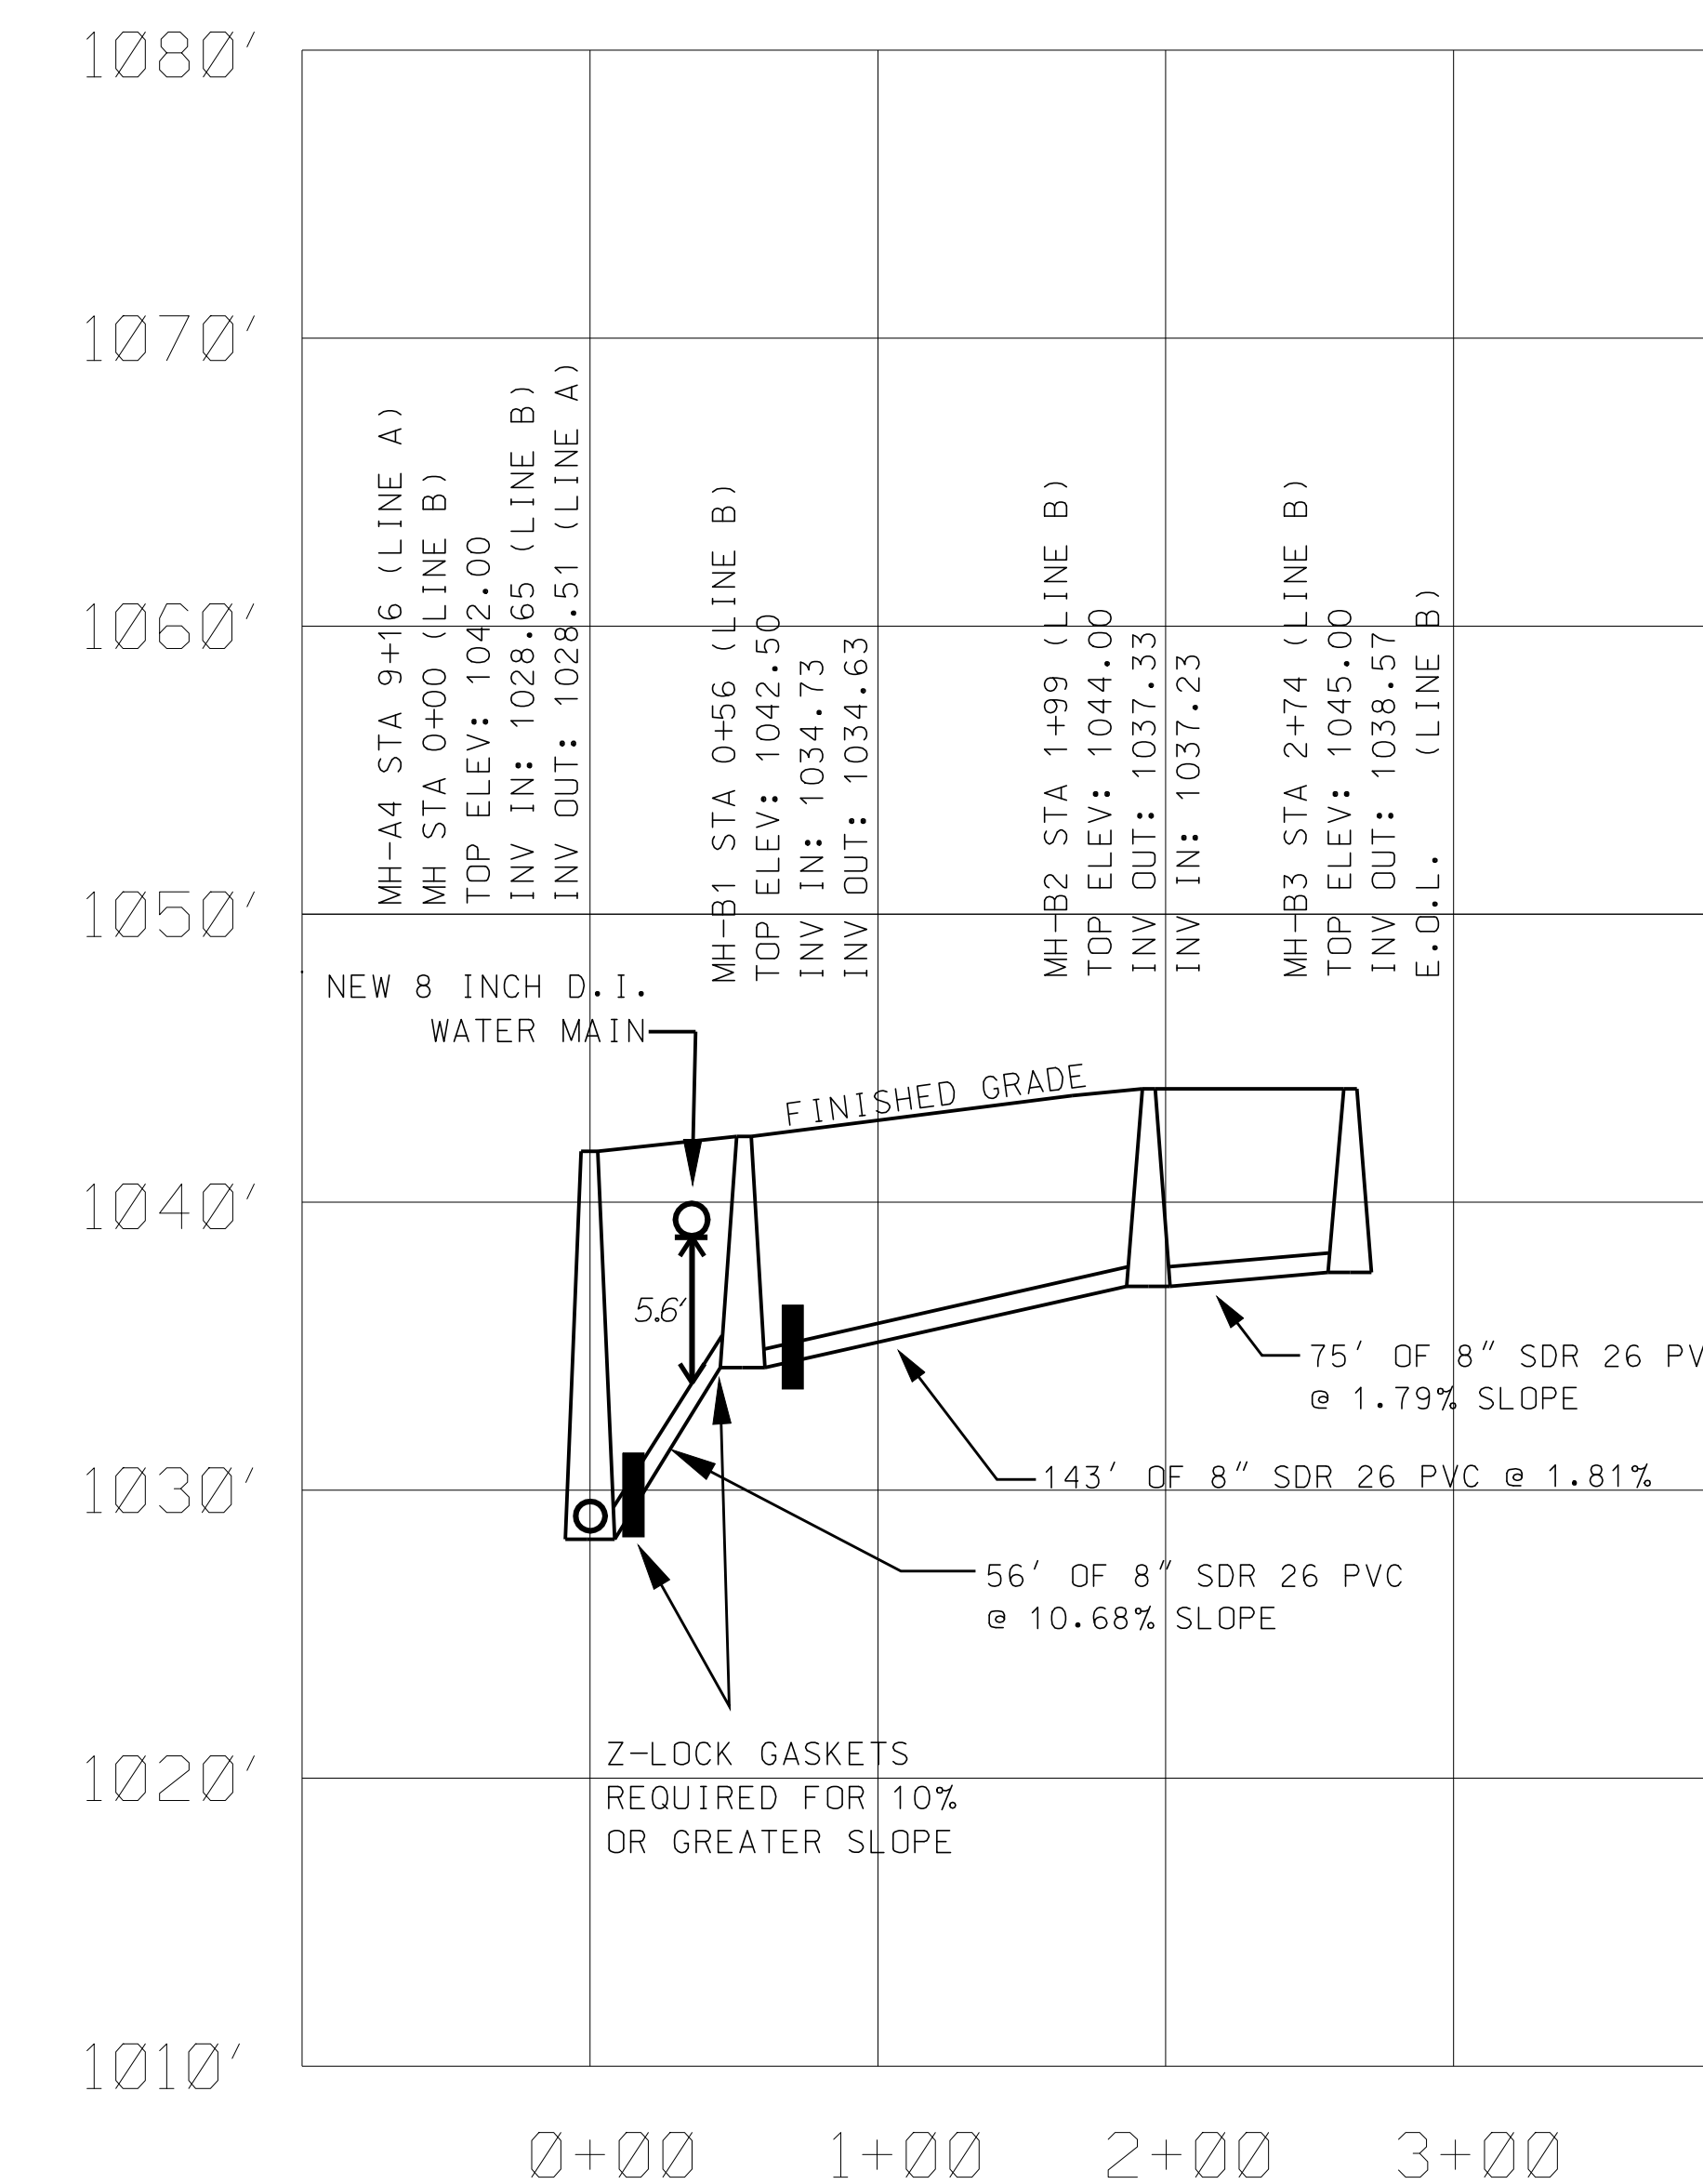

Profile Scale:  
Vertical: 1"=10'  
Horizontal: 1"=100'

**ENGINEER**  
PERFECTION ENGINEERING  
594 OLD SCHOOL LN  
KNOXVILLE, TN 37999  
(865) 426-9876

**DEVELOPER**  
BOB R. SMITH  
2468 N. SHORE DR  
JAXON, TN 36678  
(865) 391-4895

DESIGNED  
DRAWN  
CHECKED

NO. DATE

REVISION

APPR.

SCALE  
1" = 10'  
1" = 100'  
DATE  
11 - 1 - 08



KUB SUBDIVISION - PH I  
JACK RD AT OLD RD  
PUBLIC WASTEWATER ASBUILT

PE STAMP GOES HERE  
SHEET 1 OF 1 SHEETS